CORPS OF ENGINEERS

U.S. ARMY

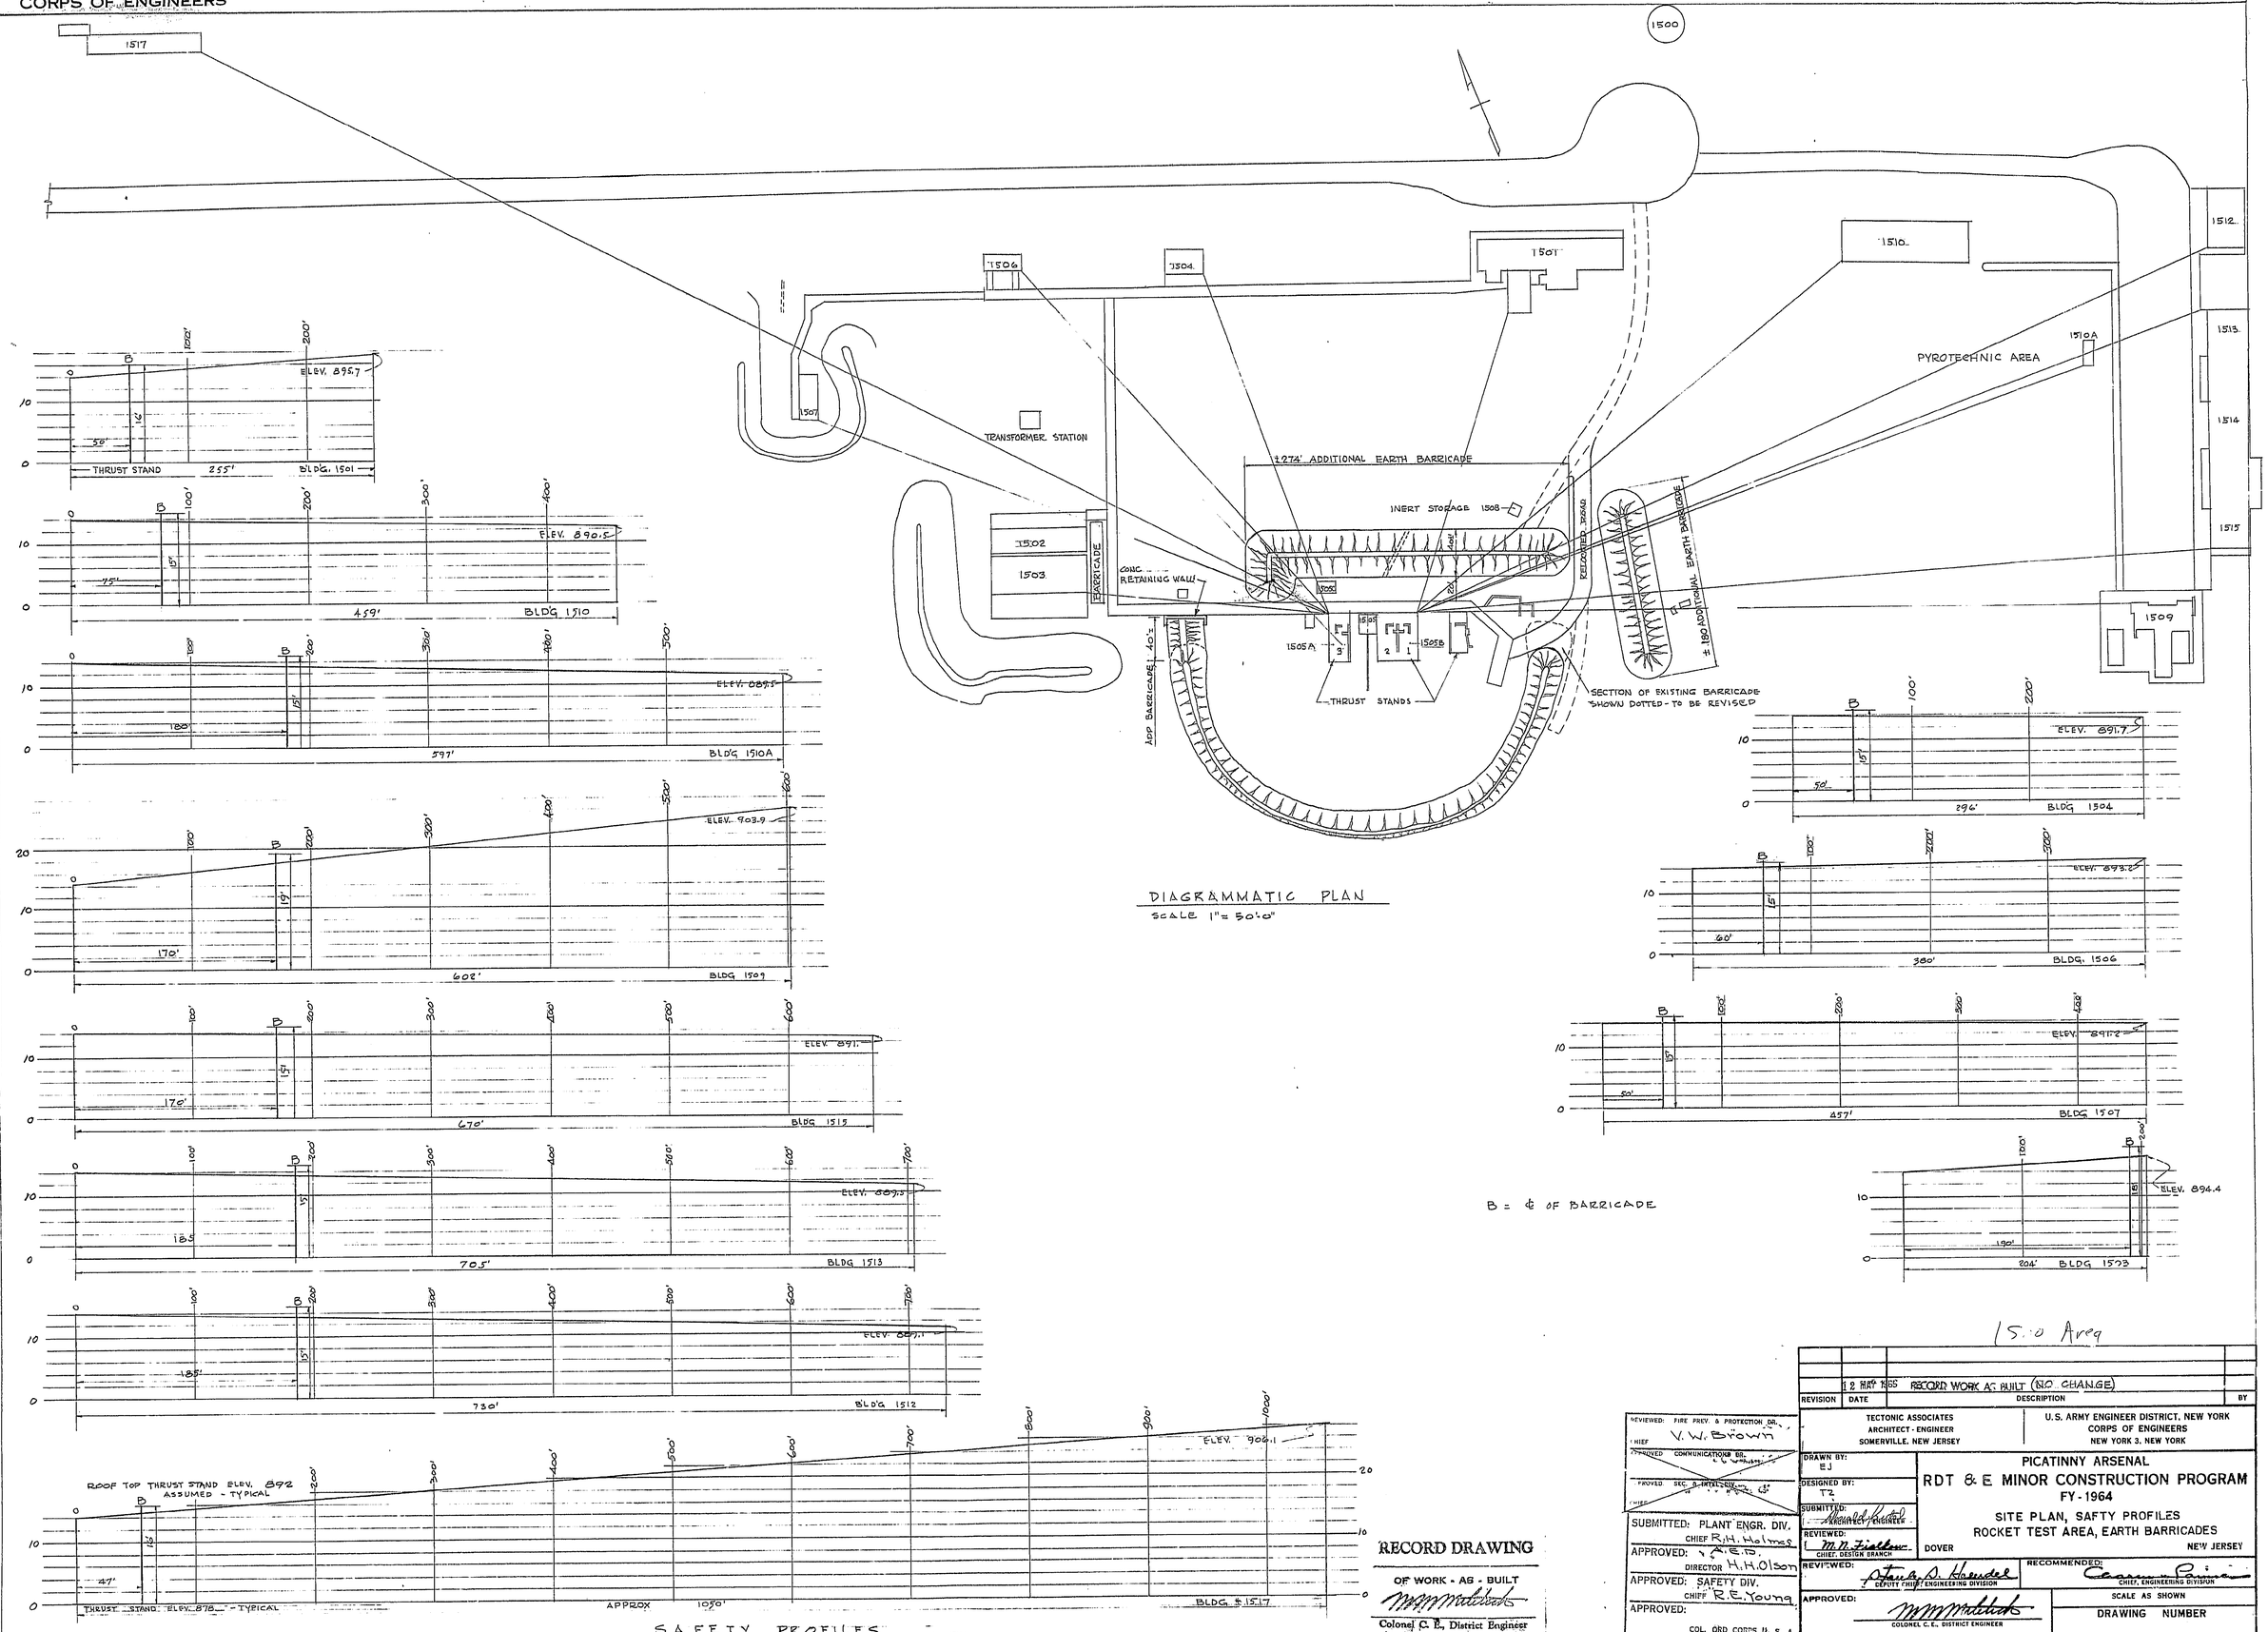

DIAGRAMMATIC PLAN

SCALE 1" = 50'-0"

B = ℄ OF BARRICADE

SAFETY PROFILES

RECORD DRAWING

OF WORK - AS - BUILT

Colonel C. E., District Engineer

15.0 Area

REVISION	DATE	DESCRIPTION	BY
	12 MAY 1965	RECORD WORK AS BUILT (NO CHANGE)	

TECTONIC ASSOCIATES
ARCHITECT - ENGINEER
SOMERVILLE, NEW JERSEY

U.S. ARMY ENGINEER DISTRICT, NEW YORK
CORPS OF ENGINEERS
NEW YORK 3, NEW YORK

REVIEWED: FIRE PREV. & PROTECTION DR.
CHIEF V. W. Brown
APPROVED COMMUNICATIONS DR.
APPROVED SEC. & INTEL. DIV.
CHIEF

SUBMITTED: PLANT ENGR. DIV.
CHIEF R.H. Holmes
APPROVED: A.E.D.
DIRECTOR H.H. Olson
APPROVED: SAFETY DIV.
CHIEF R.E. Young
APPROVED:
COL. ORD CORPS U. S. A.
COMMANDING

DRAWN BY: EJ
DESIGNED BY: TZ
SUBMITTED: Donald Kastel
ARCHITECT / ENGINEER
REVIEWED: M.N. Fialkow
CHIEF, DESIGN BRANCH

PICATINNY ARSENAL
RDT & E MINOR CONSTRUCTION PROGRAM
FY-1964
SITE PLAN, SAFTY PROFILES
ROCKET TEST AREA, EARTH BARRICADES
DOVER NEW JERSEY

REVIEWED: Stanley D. Haendel
DEPUTY CHIEF, ENGINEERING DIVISION
RECOMMENDED: Carmen Pannone
CHIEF, ENGINEERING DIVISION
APPROVED: M.M. Mitchell
COLONEL C.E., DISTRICT ENGINEER
DATE 31 MARCH 1964

SCALE AS SHOWN
DRAWING NUMBER
SHEET 28 OF 30

App. 5 May 64 H.E.

DP-141640

FILE NO. 7522-3210